

SEPTIC SYSTEM PERMIT
FLATHEAD CITY-COUNTY HEALTH DEPARTMENT
Environmental Health Services
723 5th Ave East, Kalispell, MT 59901

DATE ISSUED 9/10/93
SITE EVAL. RECEIPT

9/7-let me

1. Legal Description: Co. Assess. Tr # 6AL:6AER Sec. 26 Twn. 28 Rng. 22

150'

Subdiv. Name _____ Lot _____ Blk. _____

COS # 522 Parcel Size _____ acres

Property Address 322 NORTH FOXS LK. RD KALISPELL

2. ROBERT HELLMAN 6202 2ND DR. SE EVERETT WA.
Legal Property Owner Address and Phone

3. Authorization for: New _____ Replacement of Alteration/Repair of _____ Septic System.

4. Proposed Structure: Conv. Sing. Fam. Mob. Home _____ Multi-fam. (specify) _____
Commercial (specify) _____ Other (specify) _____

5. No. of Bedrooms 2 or No. of Occupants _____ Existing Structures _____

6. Water Supply: Indiv. Multi-user _____ Public (name) _____ Source WELL

Evaluator's Comments:

7. Soil Type and How Determined LOBBLY SAT. LOAM

8. Depth to Groundwater Table/Bedrock & How Determined 3'

System Specifications:

9. Classification 1 Septic Tank Size 1000+500 gallons (min) Absorption Area 250 sq ft

10. Drainfield Description FOLLOW PLANS & SPECIFICATIONS AS REVISED
8/11/93 BY BOB HAFERMAN. PLANS DID REQUIRE VARIANCES
TO SECTION CB(2)(d) & CB(4)(K) OF THE FLATHEAD COUNTY REGULATIONS
FOR SEWAGE TREATMENT SYSTEMS. THIS OFFICE AND ENGINEER
TO BE PRESENT DURING LEAK WATER PUMP TEST. "AS-BUILTS"
TO ACCOMPANY LETTER OF APPROVAL FROM ENGINEER PRIOR
TO FINAL APPROVAL BY THIS OFFICE.

10/6/93 EXTENDS - SEE ATTACHED LETTER
9/7/93 by Joe R. RS
Date Signature Authorizing Approval of Permit JOE RUSSELL

* These requirements establish the minimum specifications for this septic system installation. The permit will be voided and declared invalid if the system is not installed within 12 months for class 1, 2, and 4 or 24 months for class 3 and 5 systems. The issuance of this permit authorizes construction of the septic system and requires the installation comply with the FLATHEAD COUNTY REGULATIONS FOR SEWAGE TREATMENT SYSTEMS (FCRSTS). The property owner is responsible for operating and maintaining the system in accordance with FCRSTS. Failure to comply with the these regulations may result in revocation of this permit. This permit does not constitute a design and does not bind or obligate this office to guarantee the performance of the system. This permit shall be given to the installer prior to construction. The owner shall give 24 hours advanced notice for the required inspection of the system. Please call 758-5760

0355120

See "As built" drawing
by Bob Hofferman P.E.

Is source developed at time of inspection? Yes No Distribution system? Yes No

Inspector's Signature _____ Date _____ Comments _____

Inspector's Signature _____ Date 6/6/95 Comments Tested upon inspection

Glen Gray
Inspector's Signature

Ken Holloway
Name of Installer


CERTIFICATION

Sewage Treatment System Permit #93-3757R
Tracts 6AC & 6AEA, Section 26, T28N, R22W


Robert D. and Linda S. Hellman



An inspection held on June 6, 1995, on the above system revealed the project was completed in accordance with the approved plans with modifications as noted on the "As-Built" drawing enclosed. At that time, the pump furnished was producing a water column in excess of 15'. The contractor installed a valve, as noted, for throttling to produce the results shown on the "As-Built".

Attached hereto is a copy of the layout for the Keystone block retaining wall which was used in lieu of ledge rock.



Robert T. Hafferman, P.E.

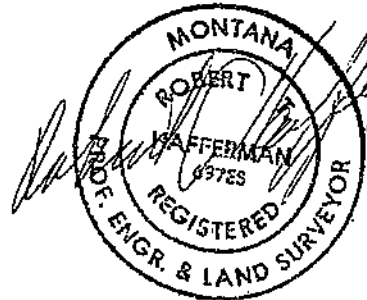

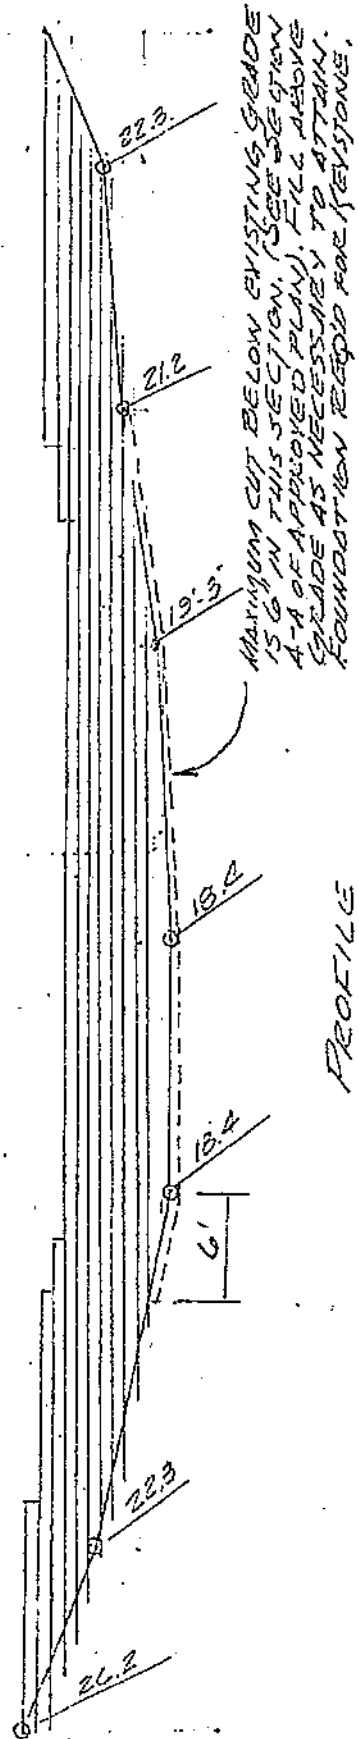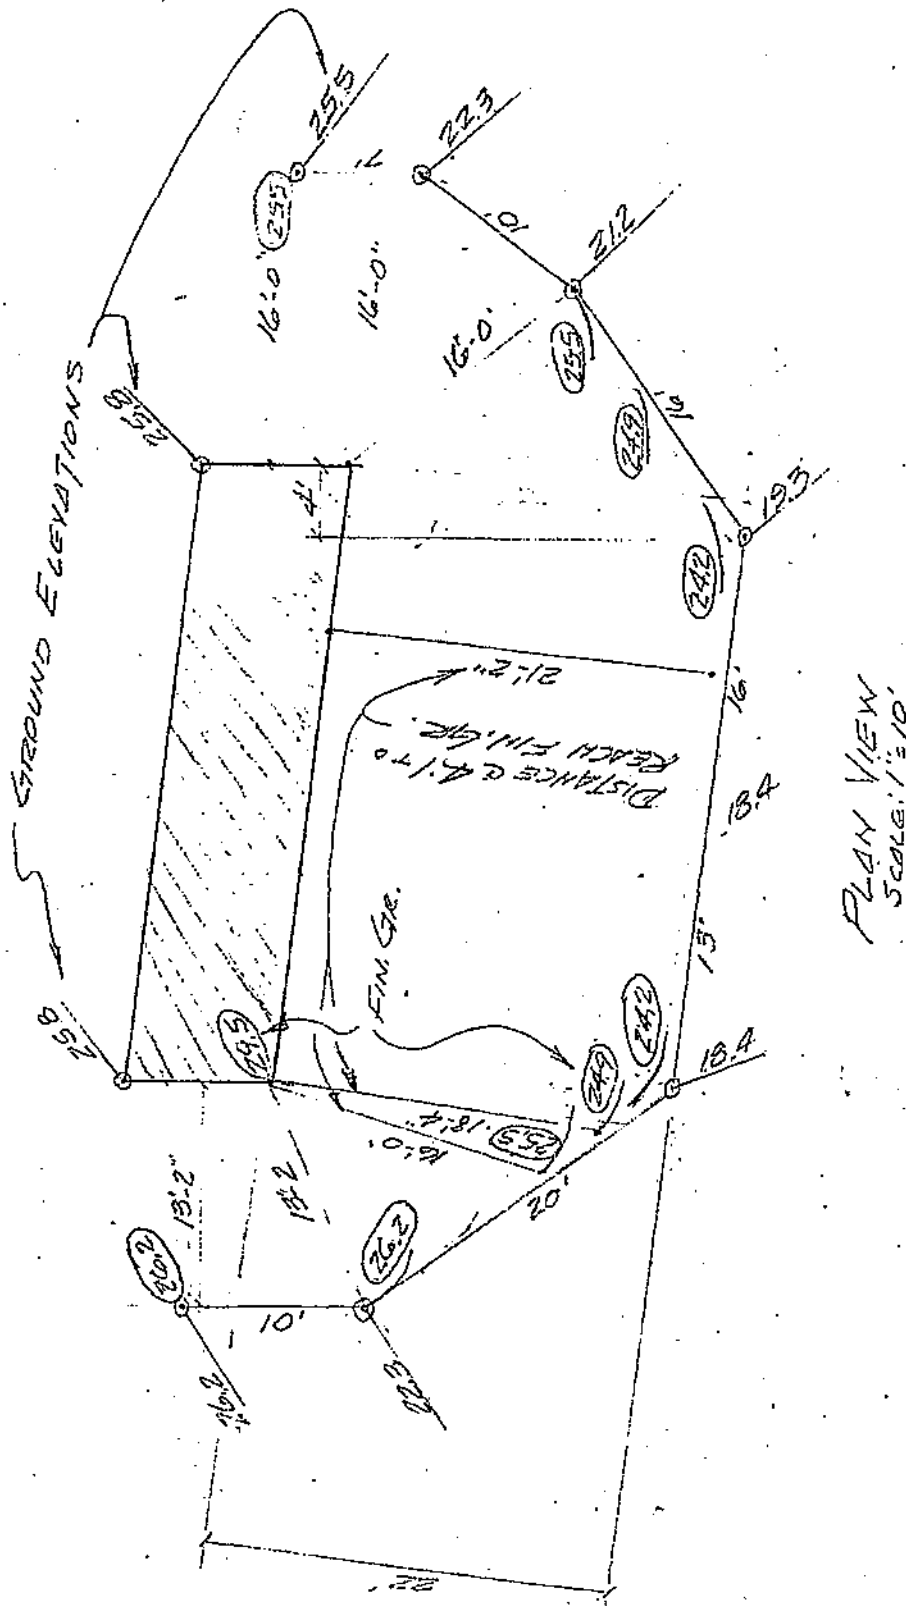

DATA FOR KEYSTONE BLOCK WALL
For: Lot GAC 66A6A, SECTION 20, T28N, R22E (WELLMAN)

KJH 9/27/93