

5-27-19

LOT 23 Echo Lake Summer Homes Lots

Over 10 Acres

Legal Description of Property

(Yes or No)

STATE OF MONTANA

Edward A. TIFFANY (Lessee)

Legal Property Owner

Property Occupant

E. Lake Shore Big Fork

Address & Phone

\$5 Fee Paid ckH 252

DENIAL OF PERMIT

If a permit is denied, a hearing before the County Board of Health, within 30 days after the receipt of a request, shall be granted.

Installer DICK CONLEY

New Remodel

Common Reasons for Denial are:

No. of Bedrooms 2

1. Sanitary Restrictions on property (see your Deed).

Septic Tank Size 750

2. Property is not recorded in Courthouse.

Water Supply LAKE EXCEPT FOR DRINKING

3. High groundwater (four-foot separation is required between drainfield and watertable.)

Soil Type GRAVEL & SAND

4. Unsuitable soil (criteria is based on site inspection and U. S. Soil Conservation Service Survey)

High Water Table —

Absorption Area 170² FT.

Describe Drainfield TWO ~~STACKED~~ dry wells in a ~~6'x6'~~ 5'x12' (elg) PIT with 1' gravel under - 6' around and 1' fill over.

SEWER LAYOUT SKETCH: Include % of slope, Property Lines, Buildings, Driveways, Water Supplies, Lakes, Creeks, Surface Water, and distances to each, ON THE REVERSE SIDE OF THIS FORM.

I HEREBY CERTIFY the information submitted herein true, complete and correct to the best of my knowledge. I will install the system according to the Flathead County Regulations for Subsurface Sewage Disposal Systems and the terms of the permit. INSPECTIONS ARE REQUIRED!

5-2-75

Date *

Edward A. Tiffany
Signature of Applicant

5-2-75

Date

E. L. Kanner

Signature of Authorized Officer Approving Permit Application

* Permit is void if system is not installed within 90 days of issuance.


Extension will be granted for 60 days upon request.

* NO FSSW code

Please phone 756-9481 for inspection when system is completely installed except for backfill.

Please notify this office at least one day in advance for prompt service. Owner may backfill if inspector misses appointment with one day's notice.

LAYOUT

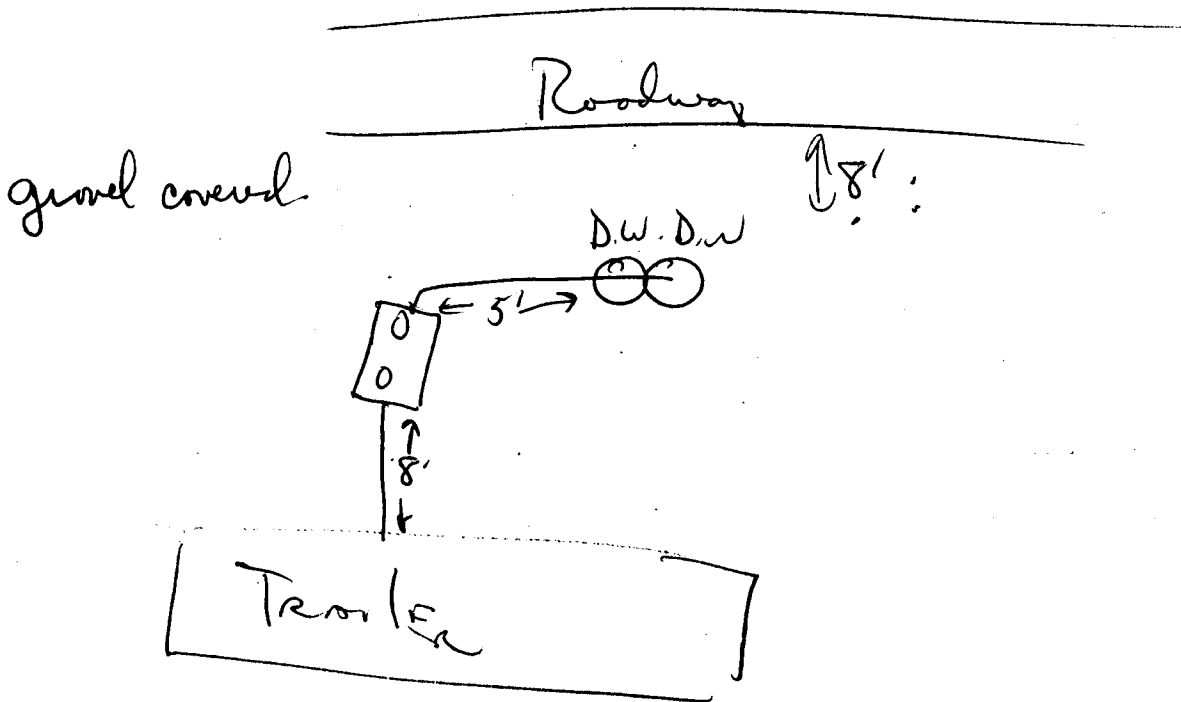

Date 6/19/75

Inspected By John R. Baker

Approved Disapproved*

*Reason for Disapproval _____

