



LAKE COUNTY ENVIRONMENTAL HEALTH DEPARTMENT  
FINAL INSPECTION AND USE PERMIT OF WASTEWATER TREATMENT SYSTEM


PROPERTY OWNER: TIM WILLIAMS  
PHYSICAL ADDRESS: LAKE TO SKY DR. BIGFORK  
LEGAL DESCRIPTION: SECTION 9110, TWP 24 N, RNG 19 W 1/2 1/4 1/4  
GEOCODE: 3469-09-1-03-04-0000 SUBDIVISION: CD5 5643 LOT: 2  
PERMIT NO: 662B CONTRACTOR: EAGLE EXCAVATING

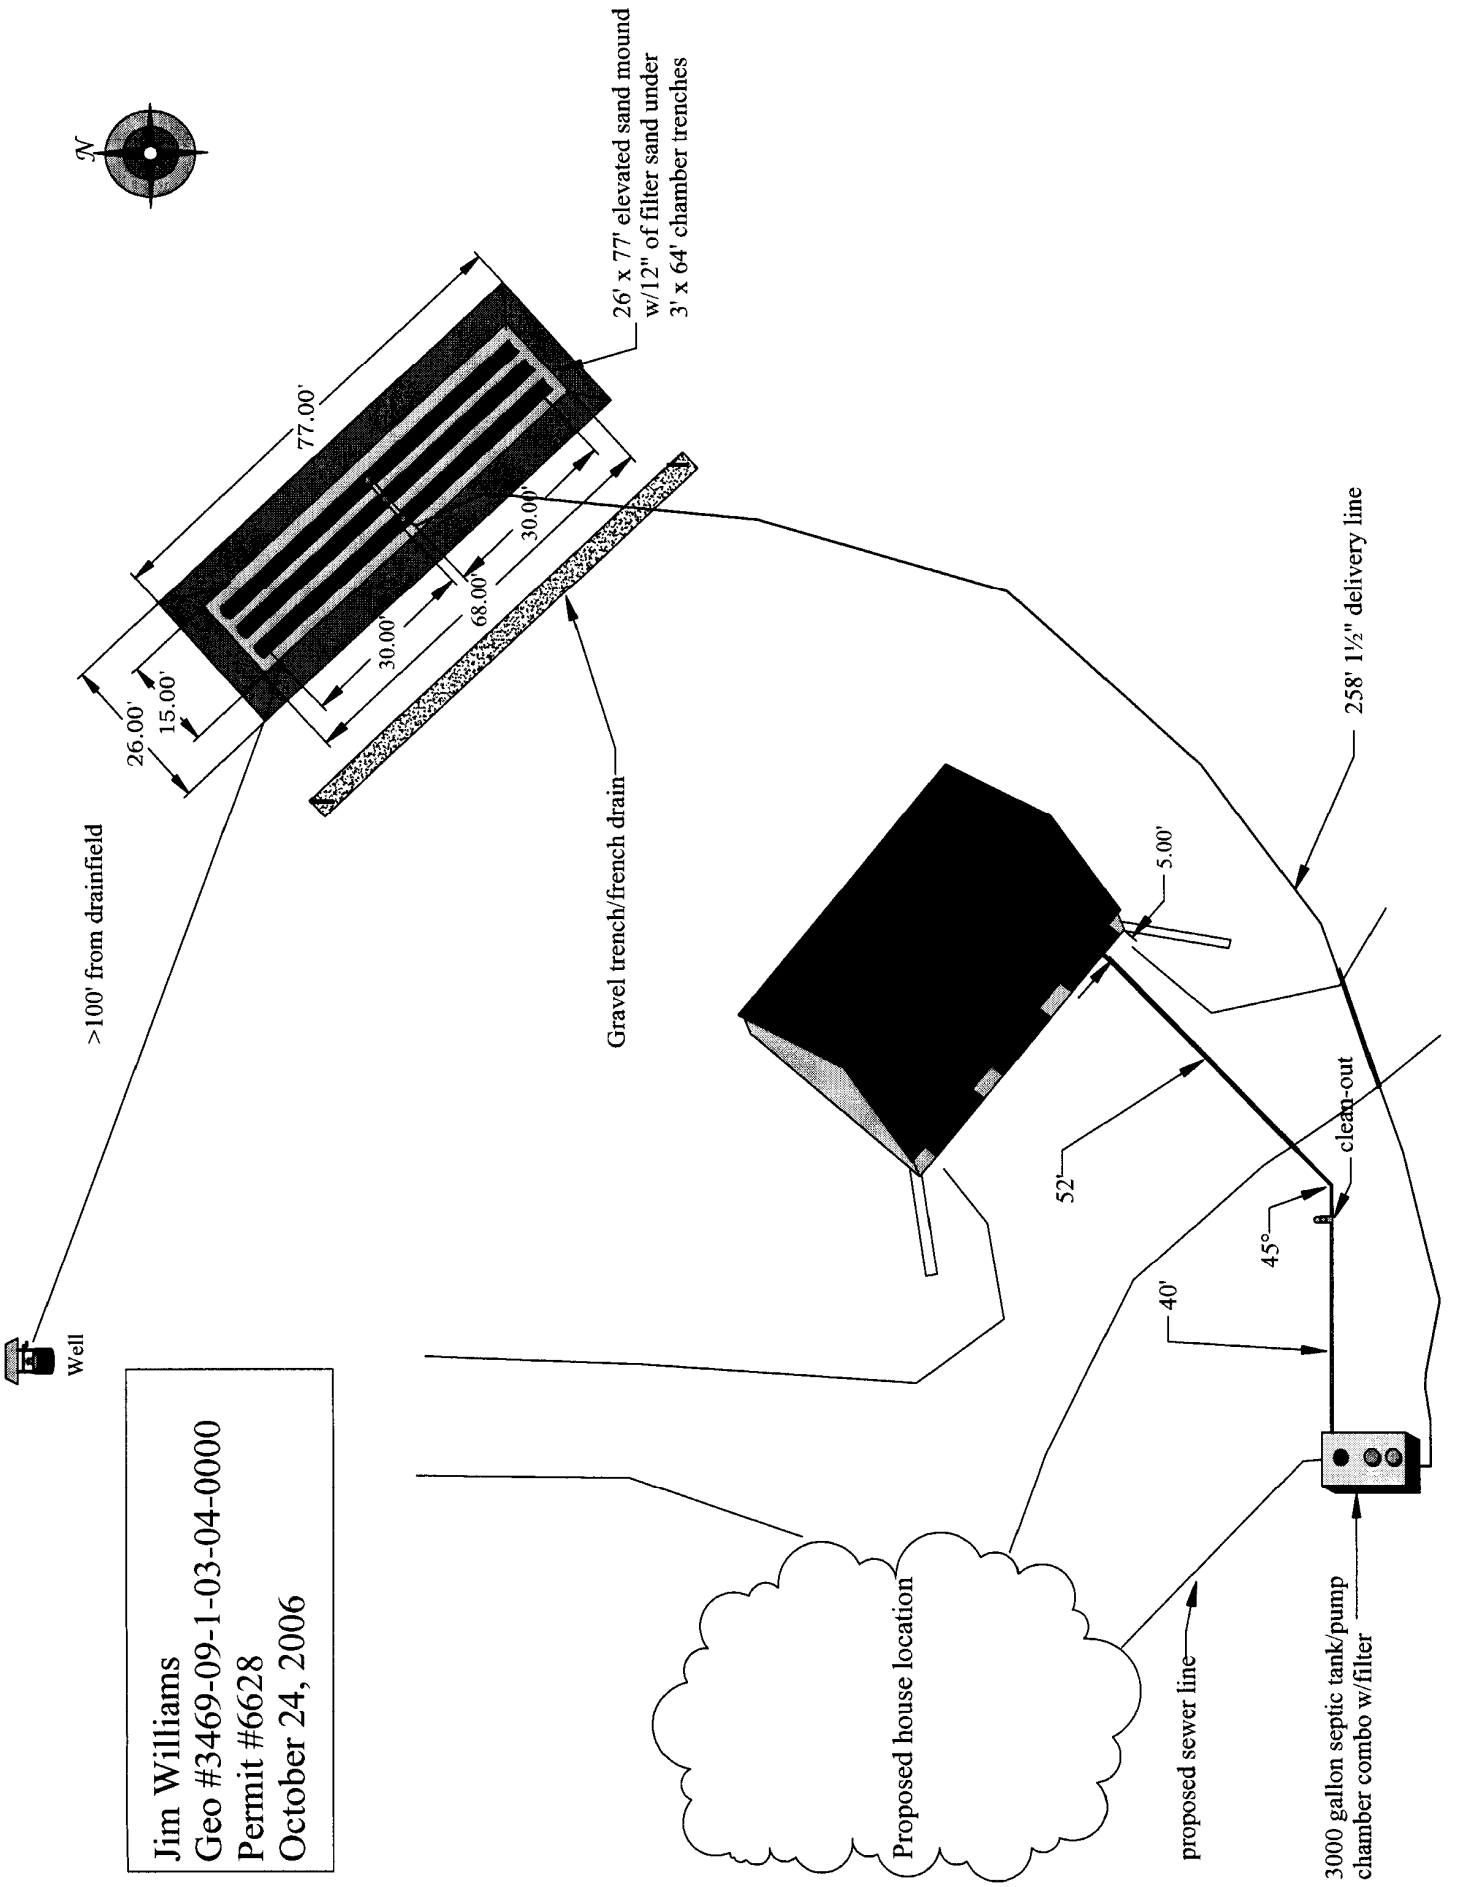

APPROVED FOR 4+2 (6) BEDROOMS 1.0 f<sup>2</sup> ~~4500~~ 575 GPD  
SEPTIC TANK: GPS-NS 261822.721 GPS-EW 410442.644  
DRAINFIELD: GPS-NS 261862.536 GPS-EW 410493.945  
INSPECTED BY: Ramin Elmwood DATE Oct 24, 2006  
SIGNATURE OF APPLICANT OR AUTHORIZED AGENT: SETA Steve THORNTON  
EAGLE EXCAVATING

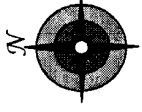

Jim Williams  
Geo #3469-09-1-03-04-0000  
Permit #6628  
October 24, 2006

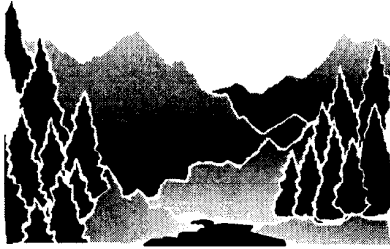

# APPLICATION FOR LAKE COUNTY WASTEWATER TREATMENT INSTALLATION PERMIT

LAKE COUNTY ENVIRONMENTAL HEALTH  
106 FOURTH AVENUE EAST  
POLSON, MT 59860-2175

PH: 406-883-7236  
FAX: 406-883-7205  
Email: envhealth@lakemt.gov

**Return the completed application with the \$150.00 permit fee to the above address.**

Property Owner: Williams, Jim Phone # (336) 248-8080 ext 22  
 Mailing Address: 115 South Main Street City Kato, Lexington State/Zip NC 27292  
 Property Address (Lake County E-911 Assigned): 1182 Lake to Sky Drive Bigfork MT 59911  
 Legal Description: Section: 9 & 10 Township 24 N Range 19 W  
 Subdivision Name: N.A. Lot 2 Block \_\_\_\_\_ Parcel Size 20.01 acres  
 Bedroom # 6 TOTAL Basement: Yes \_\_\_\_\_ No X of 55643 Garage with apartment  
 Wastewater System: (Circle) New Replacement 2 bedrooms  
 Water System: (Circle) Well Lake \_\_\_\_\_ Spring \_\_\_\_\_ Community \_\_\_\_\_ future home 4 bedroom  
 (Circle) Existing \_\_\_\_\_ Proposed \_\_\_\_\_ Property Zoned: Yes \_\_\_\_\_ No \_\_\_\_\_ Per Land Construction  
 Dwelling: (Circle) Single Family Multi-Family \_\_\_\_\_ Mobile Home \_\_\_\_\_ Commercial \_\_\_\_\_ Garage Per phone  
4 bedroom home 3 Bedroom apart.

I hereby declare that the information submitted herein is true and completed to the best of my knowledge. I understand that a final inspection and approval of the system must be conducted by Lake County Environmental Health prior to back filling and use of the system. My signature also authorizes access to the described property for purposes of reviewing this application.

Owner Signature: Len Ford (for Jim Williams) Date: 2.9.06

OFFICE USE ONLY

*per Perm Dec. 2-15-06  
Zoning Permit de*

Planning Review: East Shore Zoning 1 ailed letter 2-9-06

Geo Code: 3469-09-1-03-04 Tax Statement # 36045

Property Type: (Circle) Residential Commercial \_\_\_\_\_ Agricultural \_\_\_\_\_ Lakeshore \_\_\_\_\_

State Septic Approval: (Circle) Required \_\_\_\_\_ Completed \_\_\_\_\_ Not Required

Name: \_\_\_\_\_ Reference Date: \_\_\_\_\_ States Es # \_\_\_\_\_

Soil Type: GRAVELLY SILT loam Absorption Area Required: 1.0 gpd/ft<sup>2</sup> sandman

Contractor: Licensed in Lake County Required Septic Tank: 3000 w/pump

Drainfield Sizing Reference: # of Bedrooms 6 (4+2) Other: grinder pump for future home.

Type of Absorption Area Required: A. 26' x 77' Elevated sandman  
installed as per accompanyng specifications-



Signature of Registered Sanitarian: [Signature] Date of Issue: July 25, 2006 Permit Number: 10628 Check Number: 22924

THE DESIGN, LOCATION, & ORIENTATION OF THE DRAINFIELD MAY NOT BE ALTERED  
WITHOUT PRIOR APPROVAL FROM LAKE COUNTY ENVIRONMENTAL HEALTH.

FEB 10 2006

APPROVED PERMIT IS INVALID IF SYSTEM IS NOT INSTALLED WITHIN TWELVE MONTHS OF ISSUANCE.

A 26' X 77' elevated sandround with 12" of filter sand under 3-64' chamber trenches. See the cross-sectional view for construction details. Refer to the pump/siphon specification sheet for the lateral sizes, hole sizes, separation distances, and the lead distances.

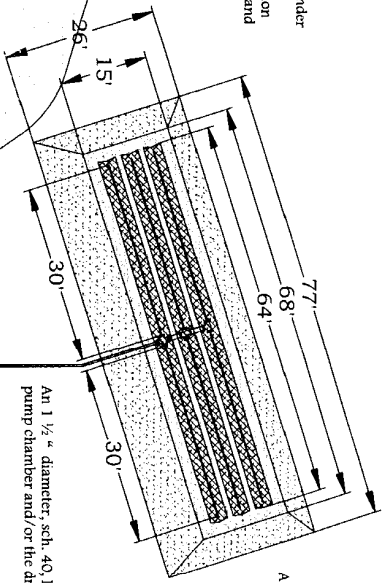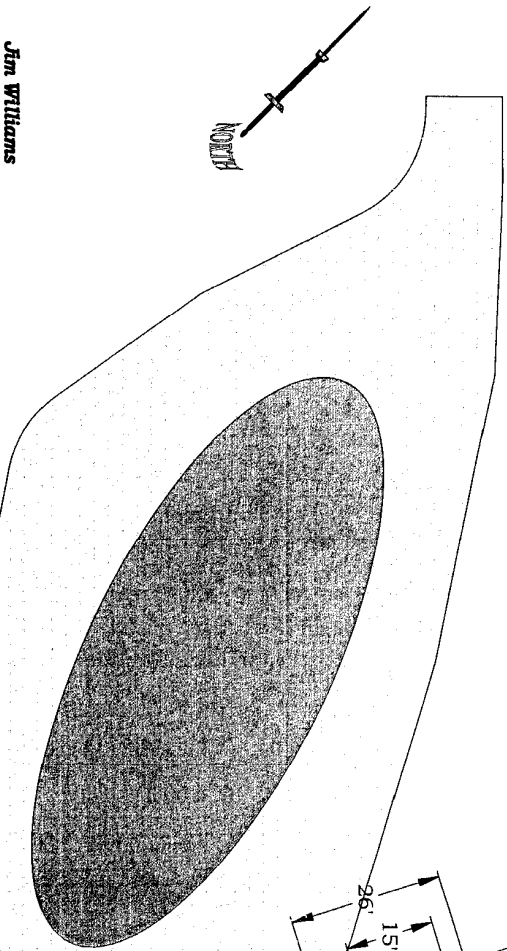


A 2" diameter, 8' long, sch. 40 manifold.

An 1 1/2" diameter, sch. 40, lift line installed to drain back to the pump chamber and/or the drainfield once the pump has shut off.

**Jim Williams**  
**1182 Lake To Sky Drive**  
**Bigfork, Montana**  
**COS 5643 Lot 2**  
**Sec. 9/10, Twn. 24N, Rng. 19W**  
**Geo-3469-09-1-03-04-0000**  
**Permit 6628 Issue July 25, 2006**

The system is lined closed, designed to retain peak flows and distribute the effluent to the drainfield over a long period of time. It requires a special pump control panel and a float setup. See the enclosed illustrations for the float separations. The on float must be set to activate the pump every 45 minutes at design flows. The override float once activated should initiate the pump cycle for 27 min each hour until the effluent level has dropped below the activation point. Refer to the control panel supplier for assistance.

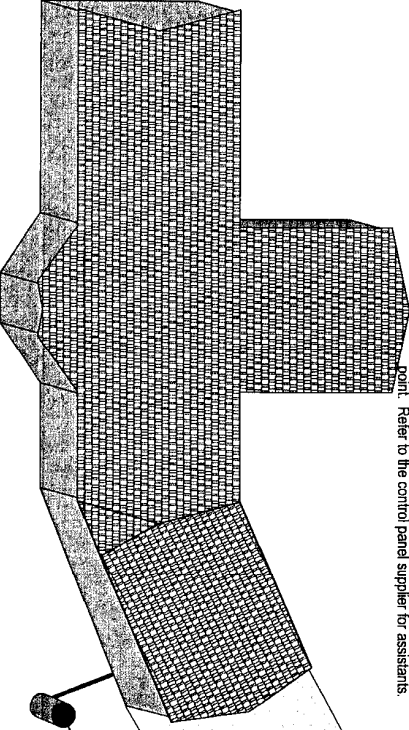


Excise the lift line in 3" diameter, sch. 40, PVC pipe at any point in which it may be impacted by vehicle traffic.

A simplex grinder pump enclosed in a manufactured vault to lift untreated sewage to the septic tank.

A 3000-gallon concrete septic tank and combination pump chamber installed as per accompanying specifications. The pump must meet or exceed the specifications set forth in the pump spec sheet. An effluent filter sized to accommodate 600-gallons of daily flow shall be installed to prevent solids from entering the pump and/or being discharged to the drainfield. Access risers must be installed to facilitate maintenance. The risers must provide surface access and the lids must afford a minimal level of security to prevent entry by children and/or animals.

4" diameter, sch. 40, PVC sewer lines sloped at 1/8" per foot from the dwelling into the septic tank. Install at least one clean-out per dwelling and an additional clean-out for every 50' of run.

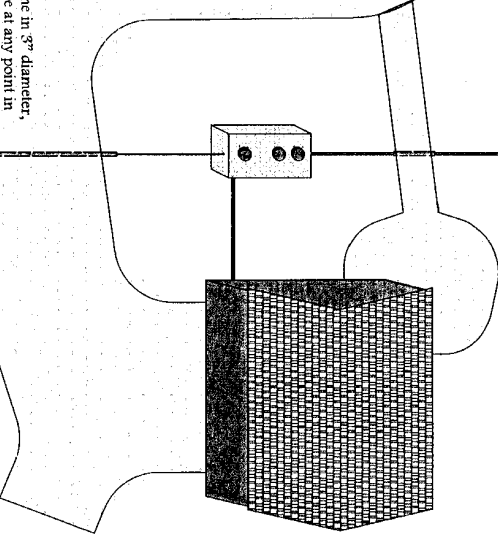



K-Value 10.27 ft/day

Flow direction South 76° West 256° degrees

**Montana Ground Water Assessment**

Elevation drop 0 ft Conversion to miles 0.56 miles  
Distance in feet 2932 ft Hydraulic gradient 0 ft/ft

**1/3 topographic**

drop 0 ft  
run 100 ft  
percent slope 0.00%  
calculated gradient 0 ft/ft  
default 0

**Triangulation**

0.05 ft/ft

i= hydraulic gradient 0.0500 f= discharge gpd 400  
d= Mixing zone thickness 15 Qf= effluent discharge 53.4  
w= width of drainfield minimum 26 p= precipitation 17  
L= length of mixing zone 287 l= prec. In ground water 0.2  
Ng= nitrogen in background ground water 1.01 conversion factor 0.0039  
Nr= nitrogen in recharge ie. Rainwater 1 nitrogen in drainfield Level II 24  
Ne= nitrogen in drainfield 50

W=.175\*L+w **W= 76.23** mixing zone width  
Am=W\*d **Am= 1143.5** mixing zone area  
As=W\*L **As= 21878** mixing zone surface area  
Qg=K\*i\*Am **Qg= 587.16** ground water volumetric rate  
Qr=As\*p\*l **Qr= 17.06** precipitation volumetric rate  
Qe=f\*Qf **Qe= 53.4** effluent volumetric rate  
Qt=Qg+Qr+Qe **Qt= 657.62** total water volumetric rate  
Nt=((Ng\*Qg)+(Nr\*Qr)+(Ne\*Qe))/Qt **Nt= 4.99** ppm nitrogen

*Nitrogen value at the end of mixing zone standard 4.99 mg/l*  
*Nitrogen value at the end of mixing zone with Level II 2.88 mg/l*

## Hydraulic Gradient calculations

static rank	well identification	well elevation	static	static elevation	horizontal distance in feet
high	Lambert 79187	3160.00	33.29	3126.71	high to mid
intermediate	Lamb 146856	3060.00	1.03	3058.97	mid to low
low	Tweto 78443	2925.00	1.64	2923.36	high to low

- A= 203.35 ft  
 B= 88.63 ft  
 C= 67.74 ft  
 D= 6003.80 ft  
 E= 1156.00 ft  
 X= 6003.80 ft  
 Hydraulic grad. 0.0586 ft/ft

High static water level=(HSWE)  
 Intermediate water level=(ISWE)

Horizontal distance=(HD)  
 Low water level=(LSWE)

A= (hswe)-(lswe)  
 C= (hswe)-(iswe)  
 X=distance D from hswe to lswe plotted on line  
 ground water flow= draw a line perpendicular to the iswe contour line through hswe  
 E=distance along ground water flow line from hswe to iswe contour line  
 Hydraulic gradient = C/E

B=(hd) between (hswe), (lswe) / A

D=B\*C=horizontal distance between the (hswe) and (lswe)=to (iswe)

Draw a line from iswe to X =static water level of iswe

Draw a line from iswe through hswe

Draw a line from hswe to iswe contour line

ft/ft

*gw flow direction : 256°*

